

Kent Homes

It makes beautiful sense

28 CHEMIN DU COUVENT

BOUCTOUCHE, NB

E4S 3B9

TEL.: (506) 743-2481

FAX.: (506) 743-2660

WWW.KENTHOMES.COM

PROPRIETARY COPYRIGHT 2017 KENT HOMES
THIS DRAWING WILL REMAIN THE PROPERTY OF KENT HOMES
WHETHER THE PROJECT FOR WHICH IT WAS MADE IS EXECUTED OR
NOT. THEY ARE NOT TO BE USED BY THE CLIENT ON ANY OTHER
PROJECTS OR EXTENSIONS TO THIS PROJECT, EXCEPT BY AGREEMENT
AND APPROPRIATE COMPENSATION TO KENT HOMES.

DISCLAIMER
THIS DESIGN DOCUMENT IS PREPARED SOLELY FOR THE USE BY THE
PARTY WITH WHOM KENT HOMES HAS ENTERED INTO A CONTRACT
AND THERE ARE NO REPRESENTATIONS OF ANY KIND MADE BY KENT
HOMES HAS NOT ENTERED INTO CONTRACT.

NO.	DESCRIPTION	DATE

CSA #

013067

DRAWN BY: C.A.S. / H.D.
CHK BY: ENG
DATE: MARCH 6, 2018
SCALE: 1/4" = 1'-0"
PROJECT NO.: 16340-R1-AS BUILT
TYPE: 32' X 56' BUNGALOW

TITLE:


MODEL HOME - #1994

LEVEL 1 PLAN

THE HOME CENTRE

SHEET NO.:

2A-101

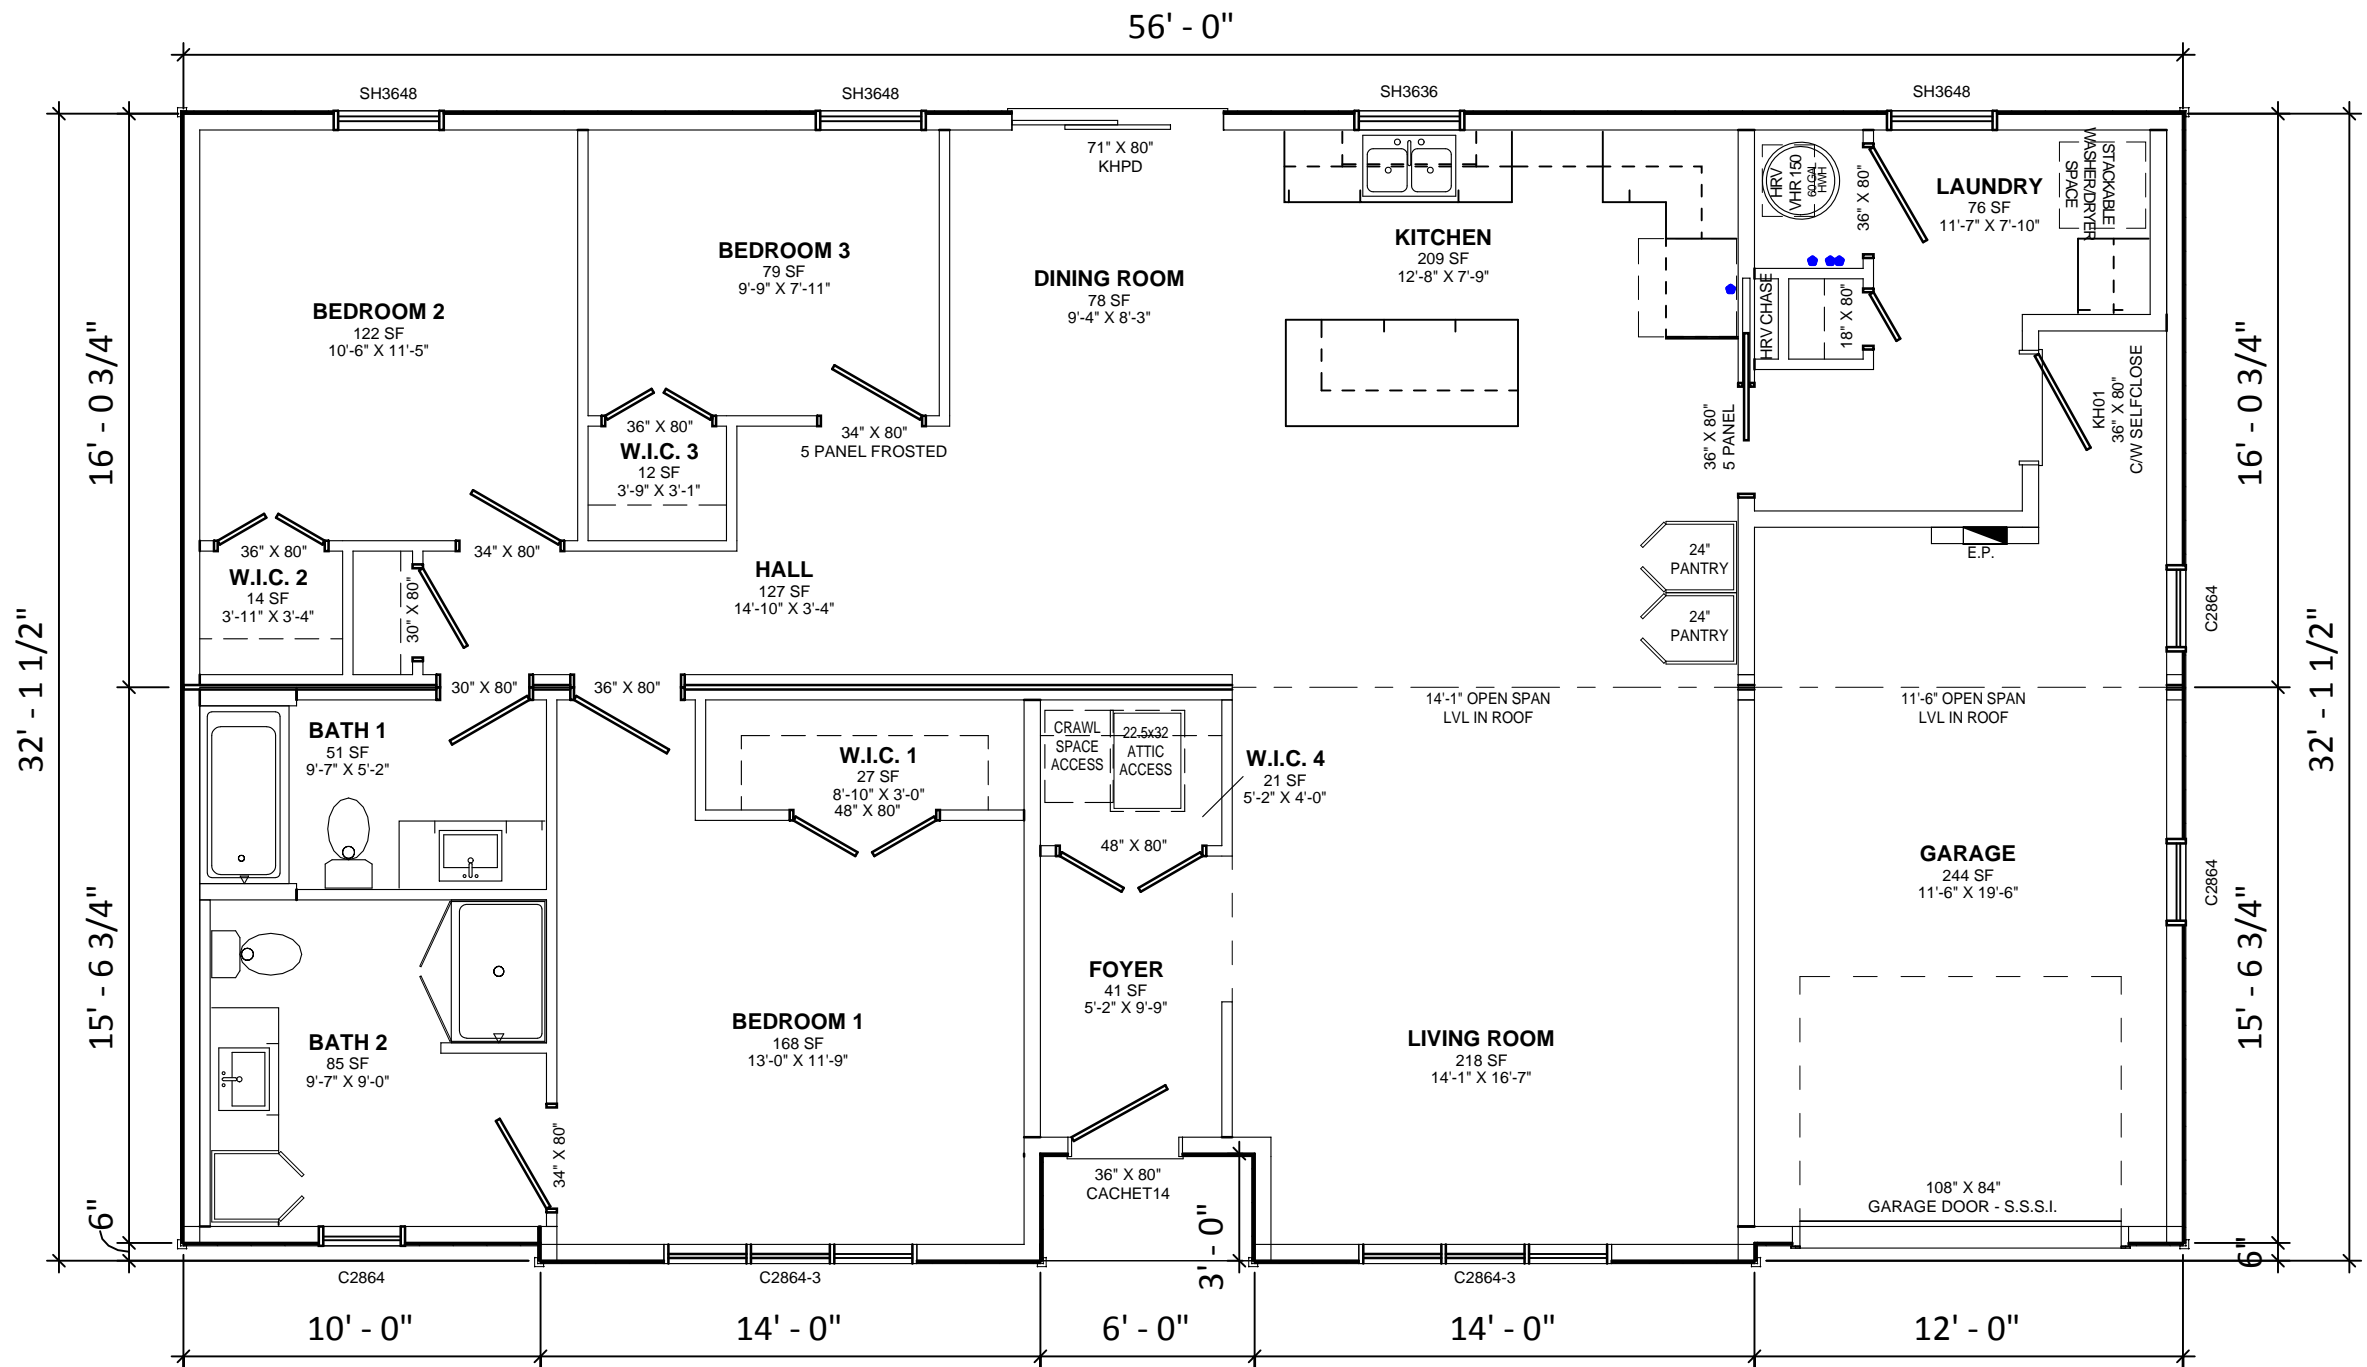

28 CHEMIN DU COUVENT
BOUCTOUCHE, NB
E4S 3B9

TEL.: (506) 743-2481
FAX.: (506) 743-2660
WWW.KENTHOMES.COM

PROPRIETARY COPYRIGHT 2017 KENT HOMES
THIS DRAWING WILL REMAIN THE PROPERTY OF KENT HOMES
WHETHER THE PROJECT FOR WHICH IT WAS MADE IS EXECUTED OR
NOT. THEY ARE NOT TO BE USED BY THE CLIENT ON ANY OTHER
PROJECTS OR EXTENSIONS TO THIS PROJECT, EXCEPT BY AGREEMENT
AND APPROPRIATE COMPENSATION TO KENT HOMES.

DISCLAIMER
THIS DESIGN DOCUMENT IS PREPARED SOLELY FOR THE USE BY THE
PARTY WITH WHOM KENT HOMES HAS ENTERED INTO A CONTRACT
AND THERE ARE NO REPRESENTATIONS OF ANY KIND MADE BY KENT
HOMES HAS NOT ENTERED INTO CONTRACT.

NO.	DESCRIPTION	DATE

CSA # 013067

DRAWN BY: C.A.S. / H.D.
CHK BY: ENG
DATE: MARCH 6, 2018
SCALE: 3/16" = 1'-0"
PROJECT NO.: 16340-R1-AS BUILT
TYPE: 32' X 56' BUNGALOW

TITLE:	MODEL HOME - #1994 LEVEL 1 PLAN THE HOME CENTRE
SHEET NO.:	2A-101.1

16340



MODULAR - FRONT ELEVATION

Kent Homes

It makes beautiful sense

28 CHEMIN DU COUVENT
BOUCTOUCHE, NB
E4S 3B9

TEL.: (506) 743-2481
FAX.: (506) 743-2660
WWW.KENTHOMES.COM

PROPRIETARY COPYRIGHT 2017 KENT HOMES
THIS DRAWING WILL REMAIN THE PROPERTY OF KENT HOMES
WHETHER THE PROJECT FOR WHICH IT WAS MADE IS EXECUTED OR
NOT. THEY ARE NOT TO BE USED BY THE CLIENT ON ANY OTHER
PROJECTS OR EXTENSIONS TO THIS PROJECT, EXCEPT BY AGREEMENT
AND APPROPRIATE COMPENSATION TO KENT HOMES.

DISCLAIMER
THIS DESIGN DOCUMENT IS PREPARED SOLELY FOR THE USE BY THE
PARTY WITH WHOM KENT HOMES HAS ENTERED INTO A CONTRACT
AND THERE ARE NO REPRESENTATIONS OF ANY KIND MADE BY KENT
HOMES HAS NOT ENTERED INTO CONTRACT.

NO.	DESCRIPTION	DATE

CSA #

013067

DRAWN BY: C.A.S. / H.D.
CHK BY: ENG
DATE: MARCH 6_2018
SCALE: 1/4" = 1'-0"
PROJECT NO.: 16340-R1-AS BUILT
TYPE: 32' X 56' BUNGALOW

TITLE:

MODEL HOME - #1994
ELEVATIONS - FRONT
THE HOME CENTRE

SHEET NO.:

2A-601

16340



MODULAR - REAR ELEVATION

Kent Homes

It makes beautiful sense

28 CHEMIN DU COUVENT
BOUCTOUCHE, NB
E4S 3B9

TEL.: (506) 743-2481
FAX.: (506) 743-2660
WWW.KENTHOMES.COM

PROPRIETARY COPYRIGHT 2017 KENT HOMES
THIS DRAWING WILL REMAIN THE PROPERTY OF KENT HOMES WHETHER THE PROJECT FOR WHICH IT WAS MADE IS EXECUTED OR NOT. THEY ARE NOT TO BE USED BY THE CLIENT ON ANY OTHER PROJECTS OR EXTENSIONS TO THIS PROJECT, EXCEPT BY AGREEMENT AND APPROPRIATE COMPENSATION TO KENT HOMES.

DISCLAIMER
THIS DESIGN DOCUMENT IS PREPARED SOLELY FOR THE USE BY THE PARTY WITH WHOM KENT HOMES HAS ENTERED INTO A CONTRACT AND THERE ARE NO REPRESENTATIONS OF ANY KIND MADE BY KENT HOMES HAS NOT ENTERED INTO CONTRACT.


NO.	DESCRIPTION	DATE

CSA #

013067

DRAWN BY: C.A.S. / H.D.
CHK BY: ENG
DATE: MARCH 6_2018
SCALE: 1/4" = 1'-0"
PROJECT NO.: 16340-R1-AS BUILT
TYPE: 32' X 56' BUNGALOW

TITLE:	MODEL HOME - #1994 ELEVATIONS - REAR THE HOME CENTRE
SHEET NO.:	2A-602

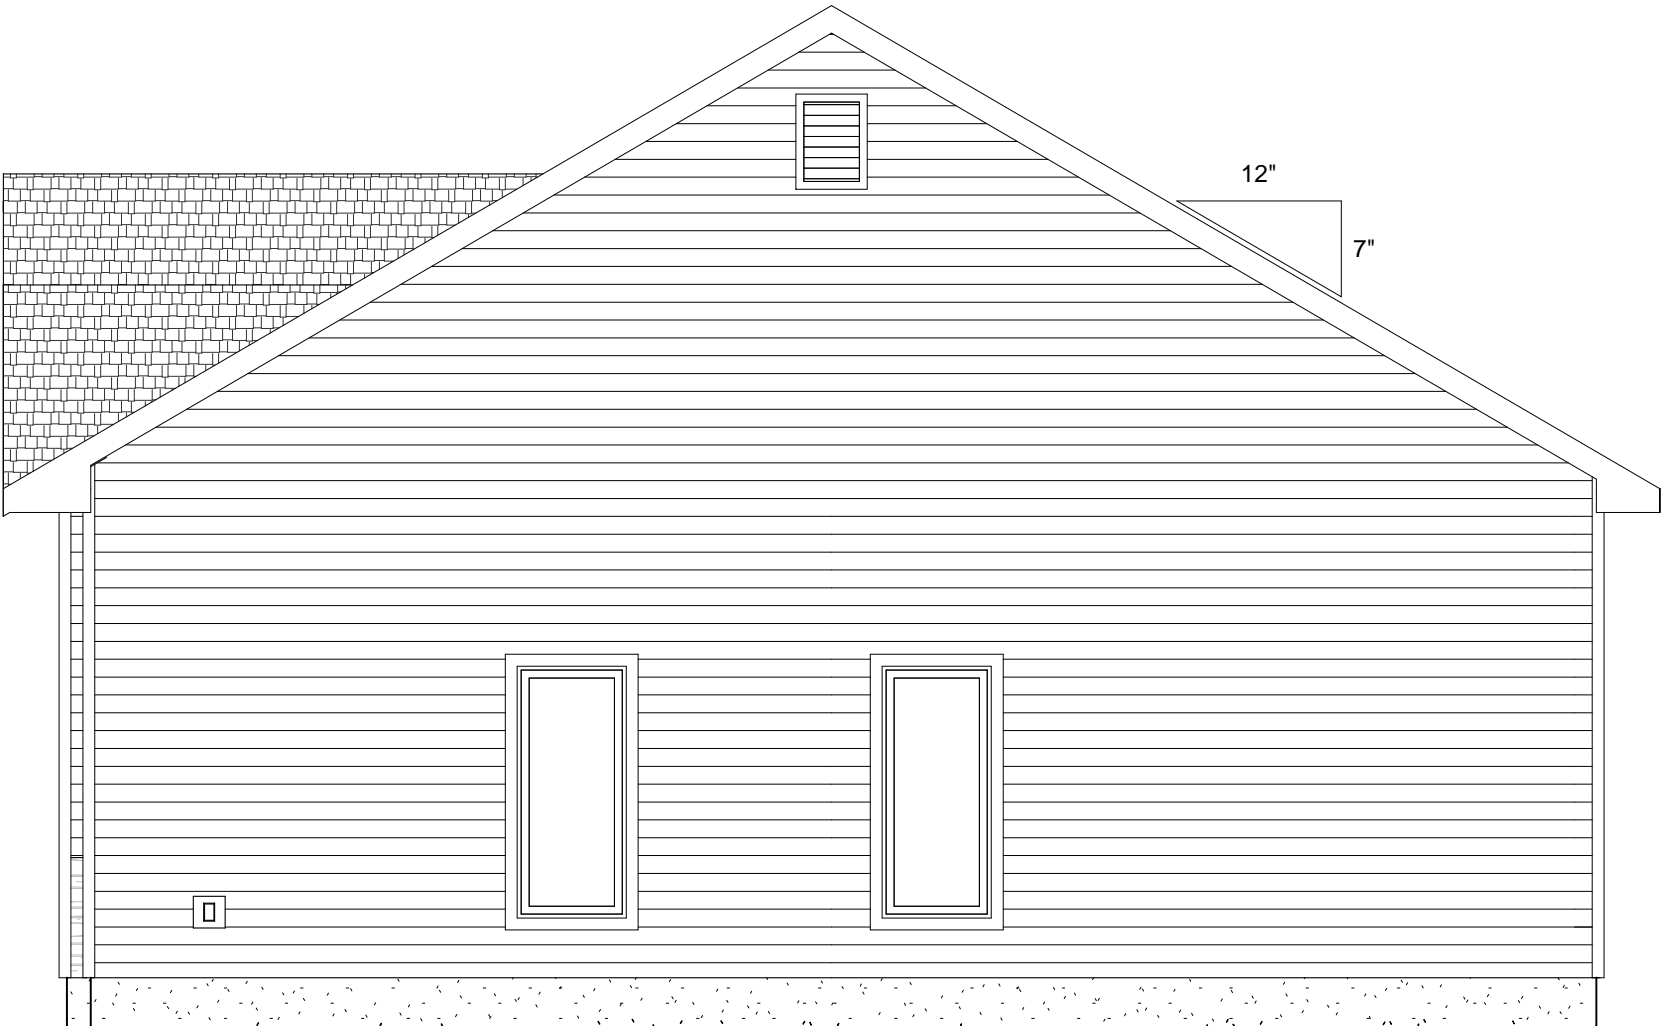

MODULAR - RIGHT ELEVATION



28 CHEMIN DU COUVENT
BOUCTOUCHE, NB
E4S 3B9

TEL.: (506) 743-2481
FAX.: (506) 743-2660
WWW.KENTHOMES.COM

PROPRIETARY COPYRIGHT 2017 KENT HOMES
THIS DRAWING WILL REMAIN THE PROPERTY OF KENT HOMES
WHETHER THE PROJECT FOR WHICH IT WAS MADE IS EXECUTED OR
NOT. THEY ARE NOT TO BE USED BY THE CLIENT ON ANY OTHER
PROJECTS OR EXTENSIONS TO THIS PROJECT, EXCEPT BY AGREEMENT
AND APPROPRIATE COMPENSATION TO KENT HOMES.


DISCLAIMER
THIS DESIGN DOCUMENT IS PREPARED SOLELY FOR THE USE BY THE
PARTY WITH WHOM KENT HOMES HAS ENTERED INTO A CONTRACT
AND THERE ARE NO REPRESENTATIONS OF ANY KIND MADE BY KENT
HOMES HAS NOT ENTERED INTO CONTRACT.

NO.	DESCRIPTION	DATE

CSA # 013067

DRAWN BY: C.A.S. / H.D.
CHK BY: ENG
DATE: MARCH 6_2018
SCALE: 1/4" = 1'-0"
PROJECT NO.: 16340-R1-AS BUILT
TYPE: 32' X 56' BUNGALOW

TITLE:	MODEL HOME - #1994 ELEVATIONS - RIGHT THE HOME CENTRE
SHEET NO.:	2A-603

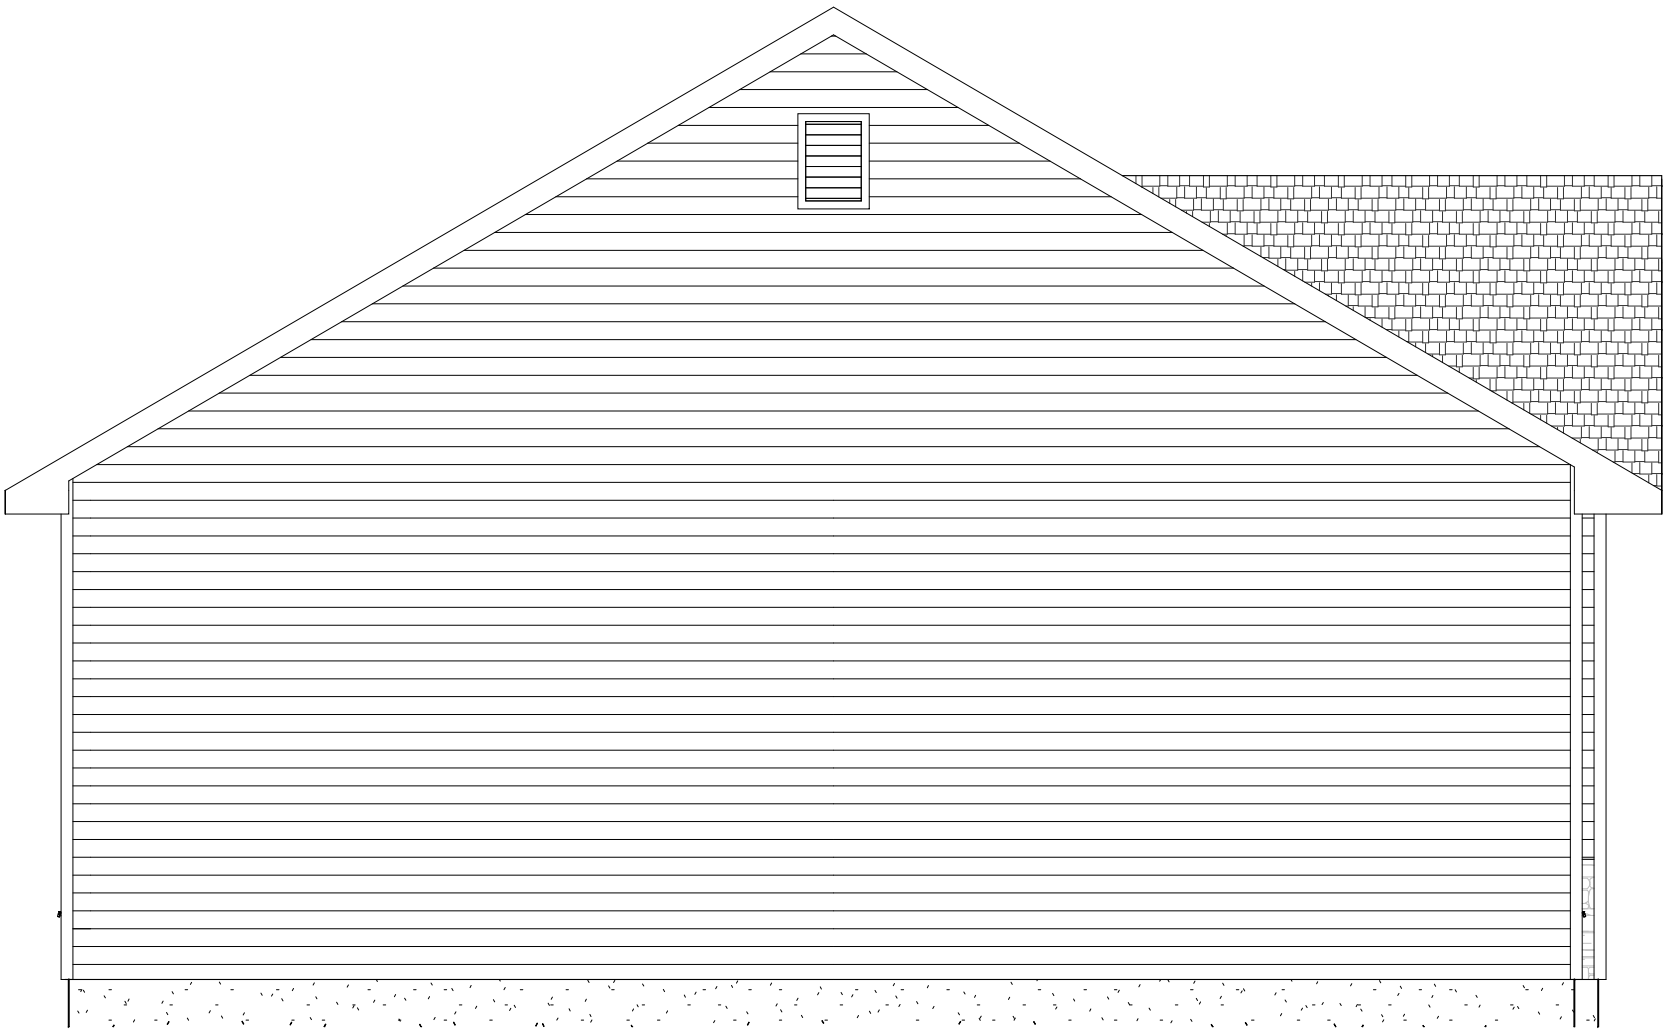

MODULAR - LEFT ELEVATION

Kent Homes

It makes beautiful sense

28 CHEMIN DU COUVENT
BOUCTOUCHE, NB
E4S 3B9

TEL.: (506) 743-2481
FAX.: (506) 743-2660
WWW.KENTHOMES.COM

PROPRIETARY COPYRIGHT 2017 KENT HOMES
THIS DRAWING WILL REMAIN THE PROPERTY OF KENT HOMES
WHETHER THE PROJECT FOR WHICH IT WAS MADE IS EXECUTED OR
NOT. THEY ARE NOT TO BE USED BY THE CLIENT ON ANY OTHER
PROJECTS OR EXTENSIONS TO THIS PROJECT, EXCEPT BY AGREEMENT
AND APPROPRIATE COMPENSATION TO KENT HOMES.

DISCLAIMER
THIS DESIGN DOCUMENT IS PREPARED SOLELY FOR THE USE BY THE
PARTY WITH WHOM KENT HOMES HAS ENTERED INTO A CONTRACT
AND THERE ARE NO REPRESENTATIONS OF ANY KIND MADE BY KENT
HOMES HAS NOT ENTERED INTO CONTRACT.

NO.	DESCRIPTION	DATE

CSA #

013067

DRAWN BY: C.A.S. / H.D.
CHK BY: ENG
DATE: MARCH 6_2018
SCALE: 1/4" = 1'-0"
PROJECT NO.: 16340-R1-AS BUILT
TYPE: 32' X 56' BUNGALOW


TITLE:

MODEL HOME - #1994
ELEVATIONS - LEFT
THE HOME CENTRE

SHEET NO.:

2A-604

FOOTING DESIGN IS BASED
UPON A MINIMUM SOIL
COMPACTION OF 3000 PSF

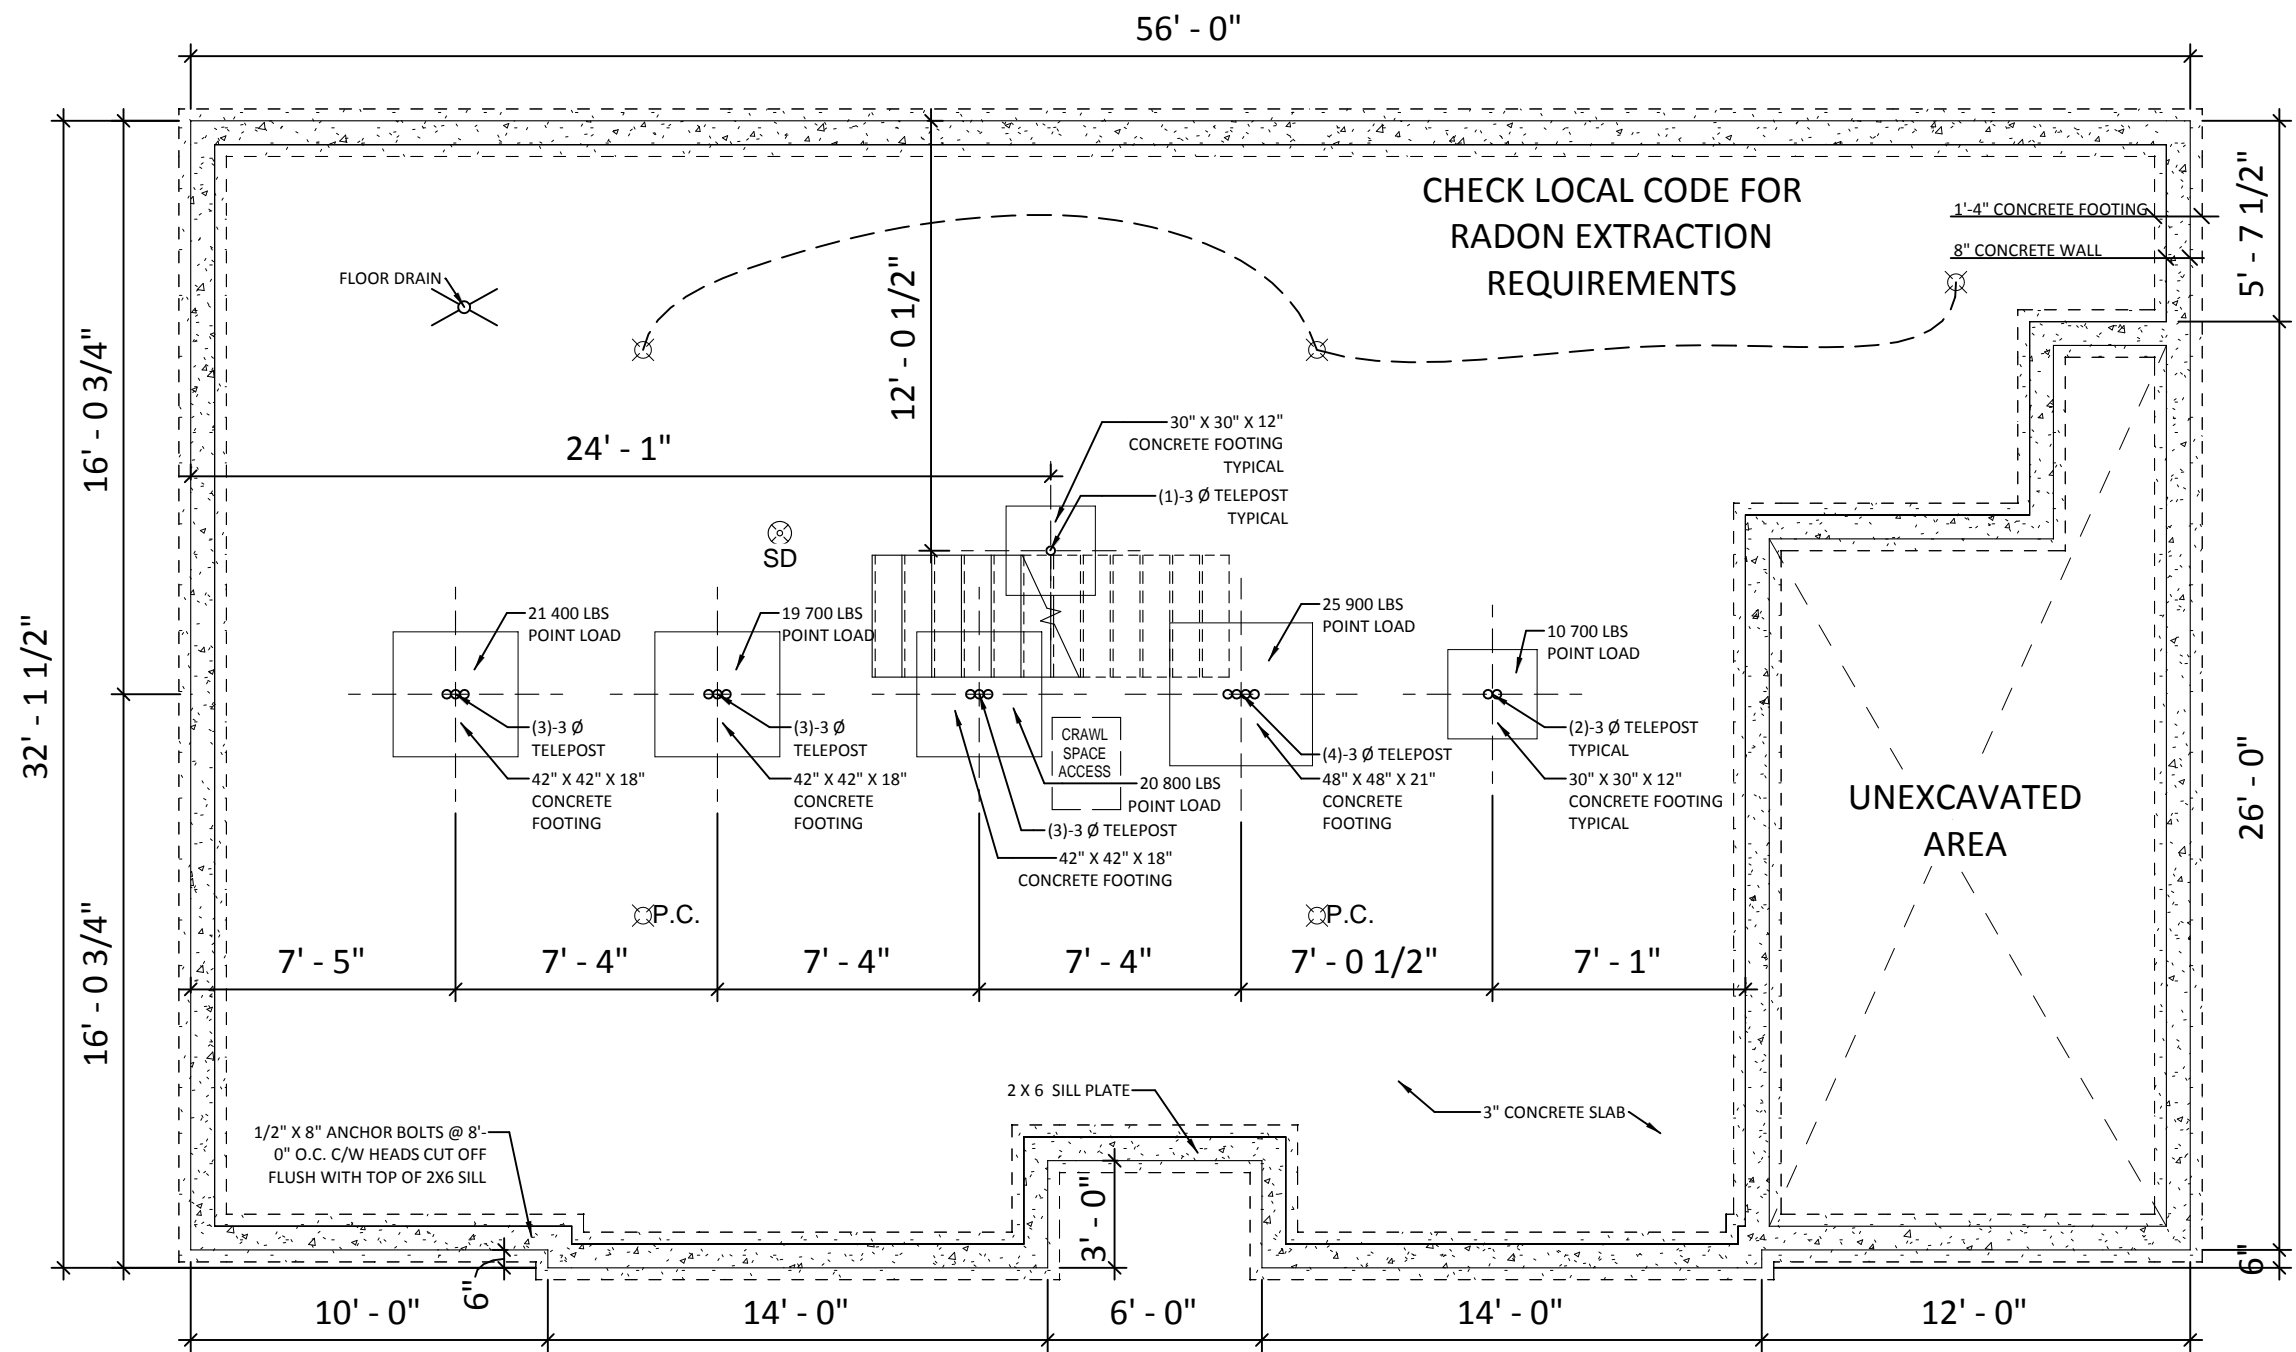

28 CHEMIN DU COUVENT
BOUCTOUCHE, NB
E4S 3B9

TEL.: (506) 743-2481
FAX.: (506) 743-2660
WWW.KENTHOMES.COM

PROPRIETARY COPYRIGHT 2017 KENT HOMES
THIS DRAWING WILL REMAIN THE PROPERTY OF KENT HOMES
WHETHER THE PROJECT FOR WHICH IT WAS MADE IS EXECUTED OR
NOT. THEY ARE NOT TO BE USED BY THE CLIENT ON ANY OTHER
PROJECTS OR EXTENSIONS TO THIS PROJECT, EXCEPT BY AGREEMENT
AND APPROPRIATE COMPENSATION TO KENT HOMES.

DISCLAIMER
THIS DESIGN DOCUMENT IS PREPARED SOLELY FOR THE USE BY THE
PARTY WITH WHOM KENT HOMES HAS ENTERED INTO A CONTRACT
AND THERE ARE NO REPRESENTATIONS OF ANY KIND MADE BY KENT
HOMES HAS NOT ENTERED INTO CONTRACT.

NO.	DESCRIPTION	DATE

CSA # 013067

DRAWN BY: C.A.S. / H.D.
CHK BY: ENG
DATE: MARCH 6, 2018
SCALE: 3/16" = 1'-0"
PROJECT NO.: 16340-R1-AS BUILT
TYPE: 32' X 56' BUNGALOW

TITLE:	MODEL HOME - #1994 LEVEL 0 PLAN THE HOME CENTRE
SHEET NO.:	2S-101


16340

FOOTING DESIGN IS BASED
UPON A MINIMUM SOIL
COMPACTION OF 3000 PSF

LEGEND

P.S.S.I. = PLANT SUPPLIED SITE INSTALLED

S.S.S.I. = SITE SUPPLIED SITE INSTALLED

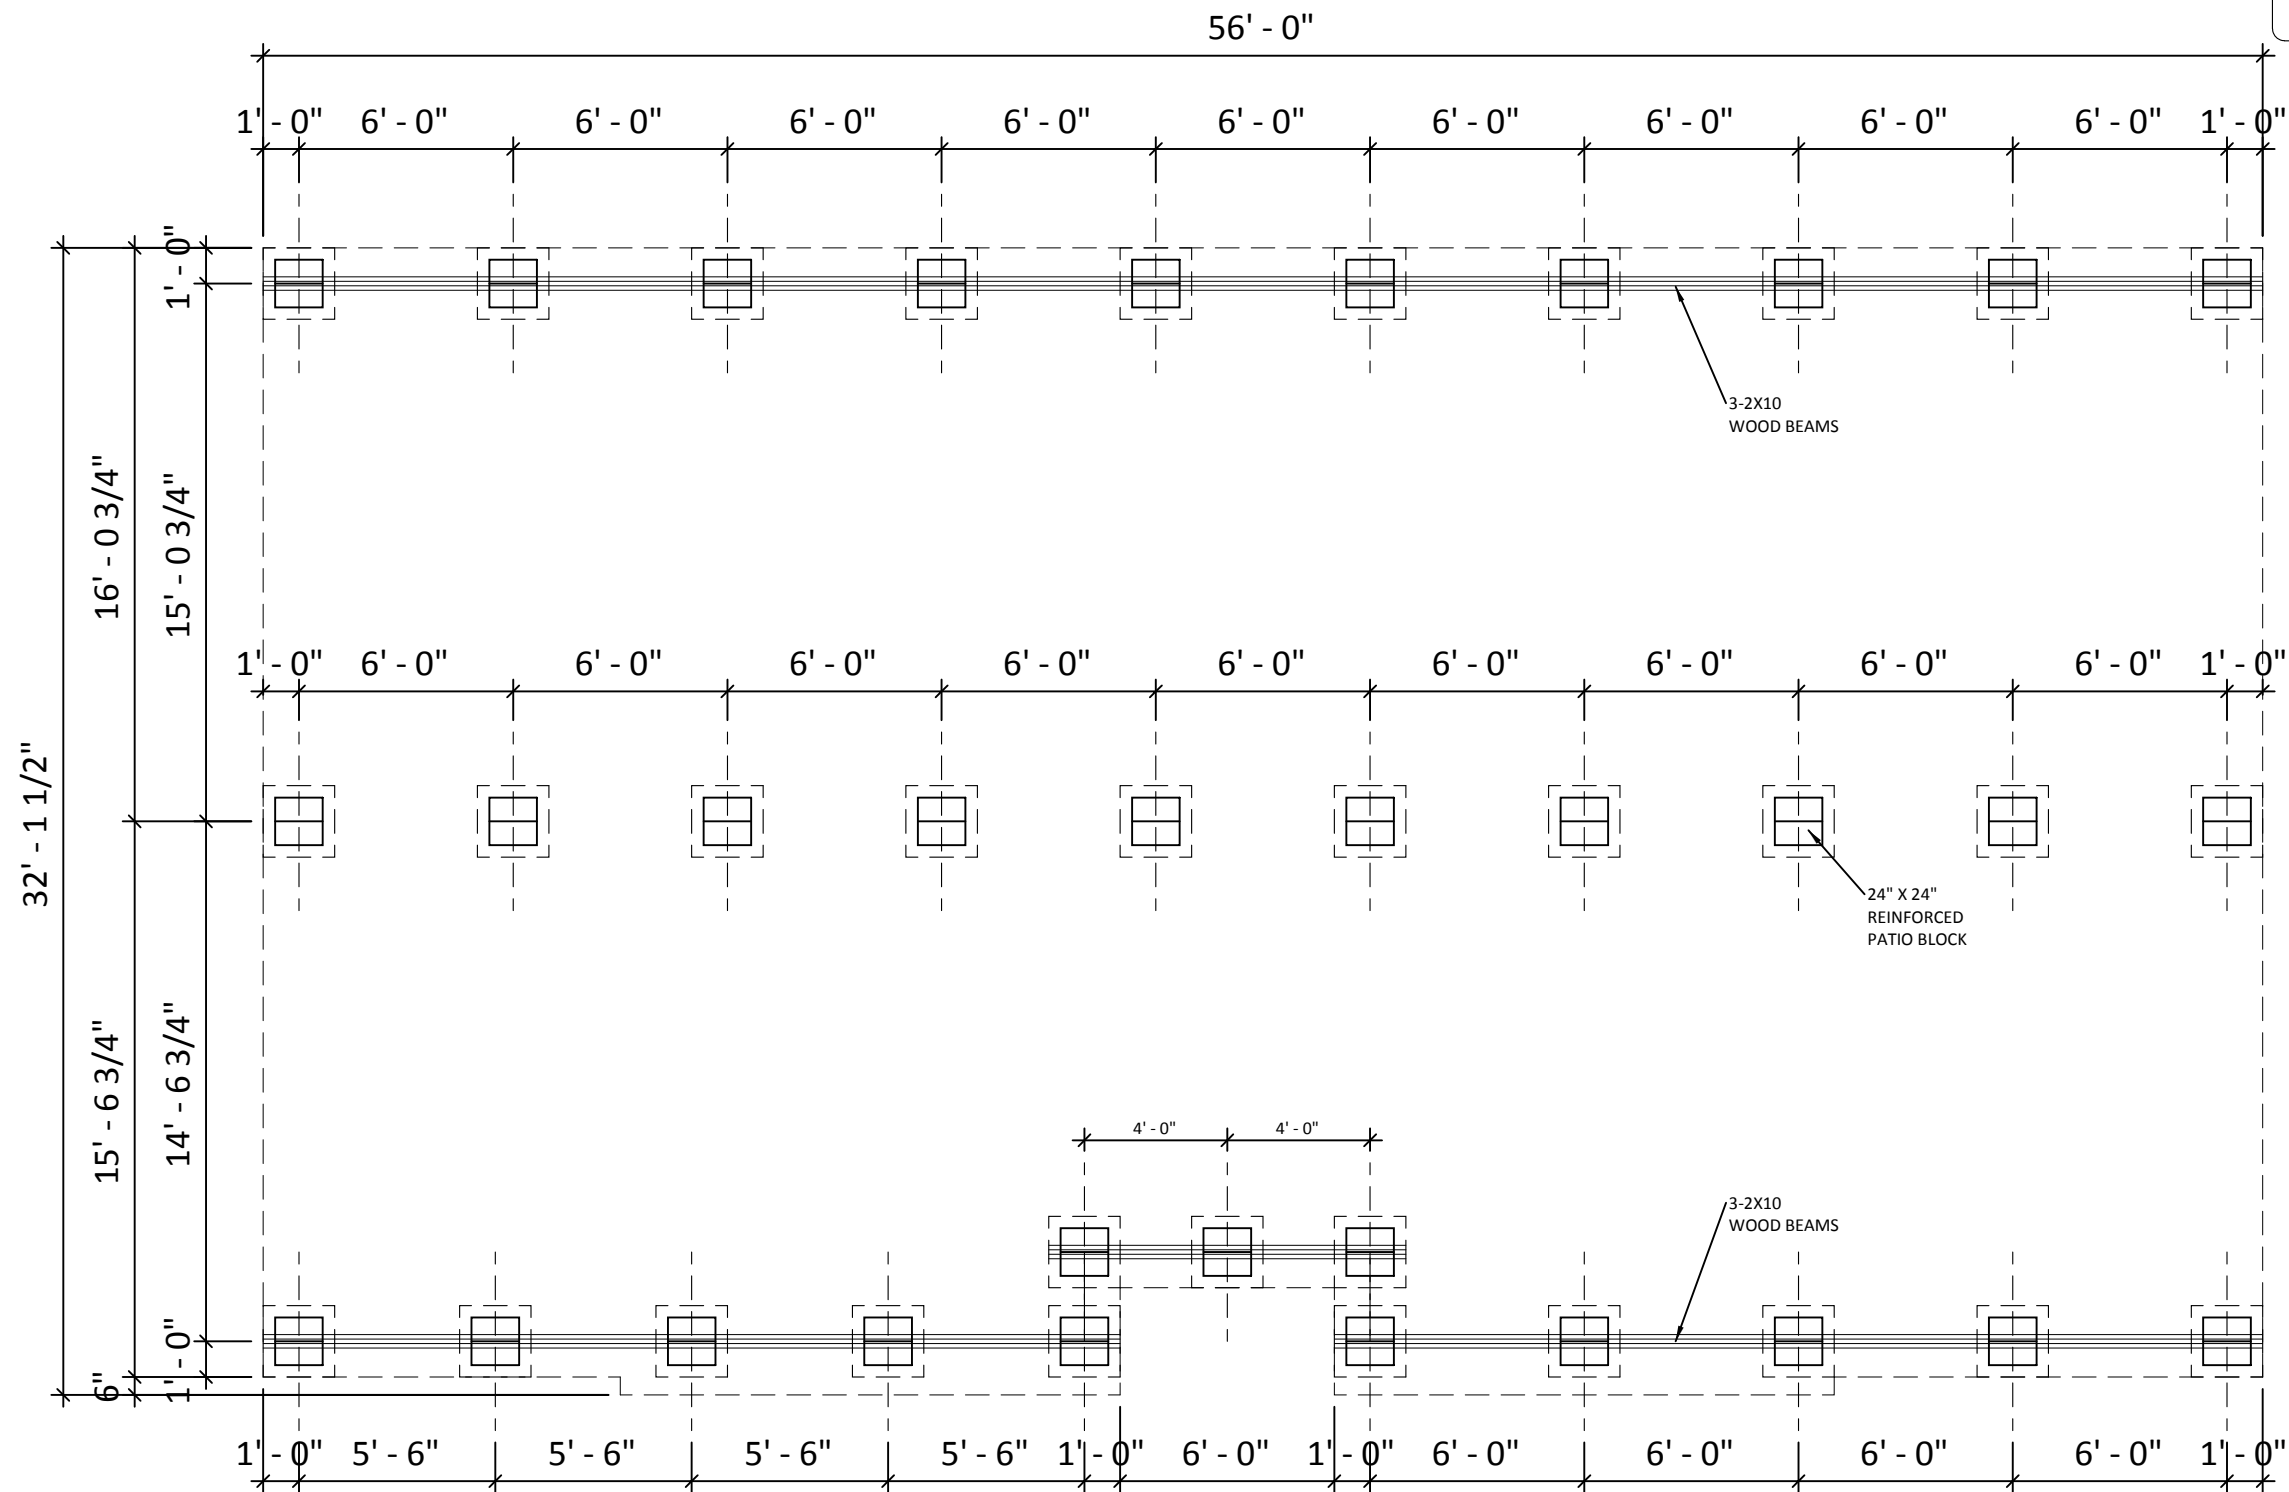

Kent Homes

It makes beautiful sense

28 CHEMIN DU COUVENT
BOUCTOUCHE, NB
E4S 3B9

TEL.: (506) 743-2481
FAX.: (506) 743-2660
WWW.KENTHOMES.COM

PROPRIETARY COPYRIGHT 2017 KENT HOMES

THIS DRAWING WILL REMAIN THE PROPERTY OF KENT HOMES WHETHER THE PROJECT FOR WHICH IT WAS MADE IS EXECUTED OR NOT. THEY ARE NOT TO BE USED BY THE CLIENT ON ANY OTHER PROJECTS OR EXTENSIONS TO THIS PROJECT, EXCEPT BY AGREEMENT AND APPROPRIATE COMPENSATION TO KENT HOMES.

DISCLAIMER

THIS DESIGN DOCUMENT IS PREPARED SOLELY FOR THE USE BY THE PARTY WITH WHOM KENT HOMES HAS ENTERED INTO A CONTRACT AND THERE ARE NO REPRESENTATIONS OF ANY KIND MADE BY KENT HOMES HAS NOT ENTERED INTO CONTRACT.

NO.	DESCRIPTION	DATE

CSA # 013067

DRAWN BY: C.A.S. / H.D.

CHK BY: ENG

DATE: MARCH 6, 2018

SCALE: 3/16" = 1'-0"

PROJECT NO.: 16340-R1-AS BUILT

TYPE: 32' X 56' BUNGALOW

TITLE:

MODEL HOME - #1994

LEVEL 0 PLAN

THE HOME CENTRE

SHEET NO.:

2S-102