

Kent Homes

It makes beautiful sense

28 CHEMIN DU COUVENT

BOUCTOUCHE, NB

E4S 3B9

TEL.: (506) 743-2481

FAX.: (506) 743-2660

WWW.KENTHOMES.COM

PROPRIETARY COPYRIGHT 2017 KENT HOMES
THIS DRAWING WILL REMAIN THE PROPERTY OF KENT HOMES
WHETHER THE PROJECT FOR WHICH IT WAS MADE IS EXECUTED OR
NOT. THEY ARE NOT TO BE USED BY THE CLIENT ON ANY OTHER
PROJECTS OR EXTENSIONS TO THIS PROJECT, EXCEPT BY AGREEMENT
AND APPROPRIATE COMPENSATION TO KENT HOMES.

DISCLAIMER
THIS DESIGN DOCUMENT IS PREPARED SOLELY FOR THE USE BY THE
PARTY WITH WHOM KENT HOMES HAS ENTERED INTO A CONTRACT
AND THERE ARE NO REPRESENTATIONS OF ANY KIND MADE BY KENT
HOMES HAS NOT ENTERED INTO CONTRACT.

NO.	DESCRIPTION	DATE

DRAWN BY: C.A.S.

CHK BY: ENG

DATE: NOVEMBER 6_2017

SCALE: 3/16" = 1'-0"

PROJECT NO.: 56738-R2-AS BUILT

TYPE: 16'-0" X 75'-0" TECH HOME

TITLE:


#1989 - OFFICE

LEVEL 1 PLAN


THE HOME CENTER

SHEET NO.:

2A-101

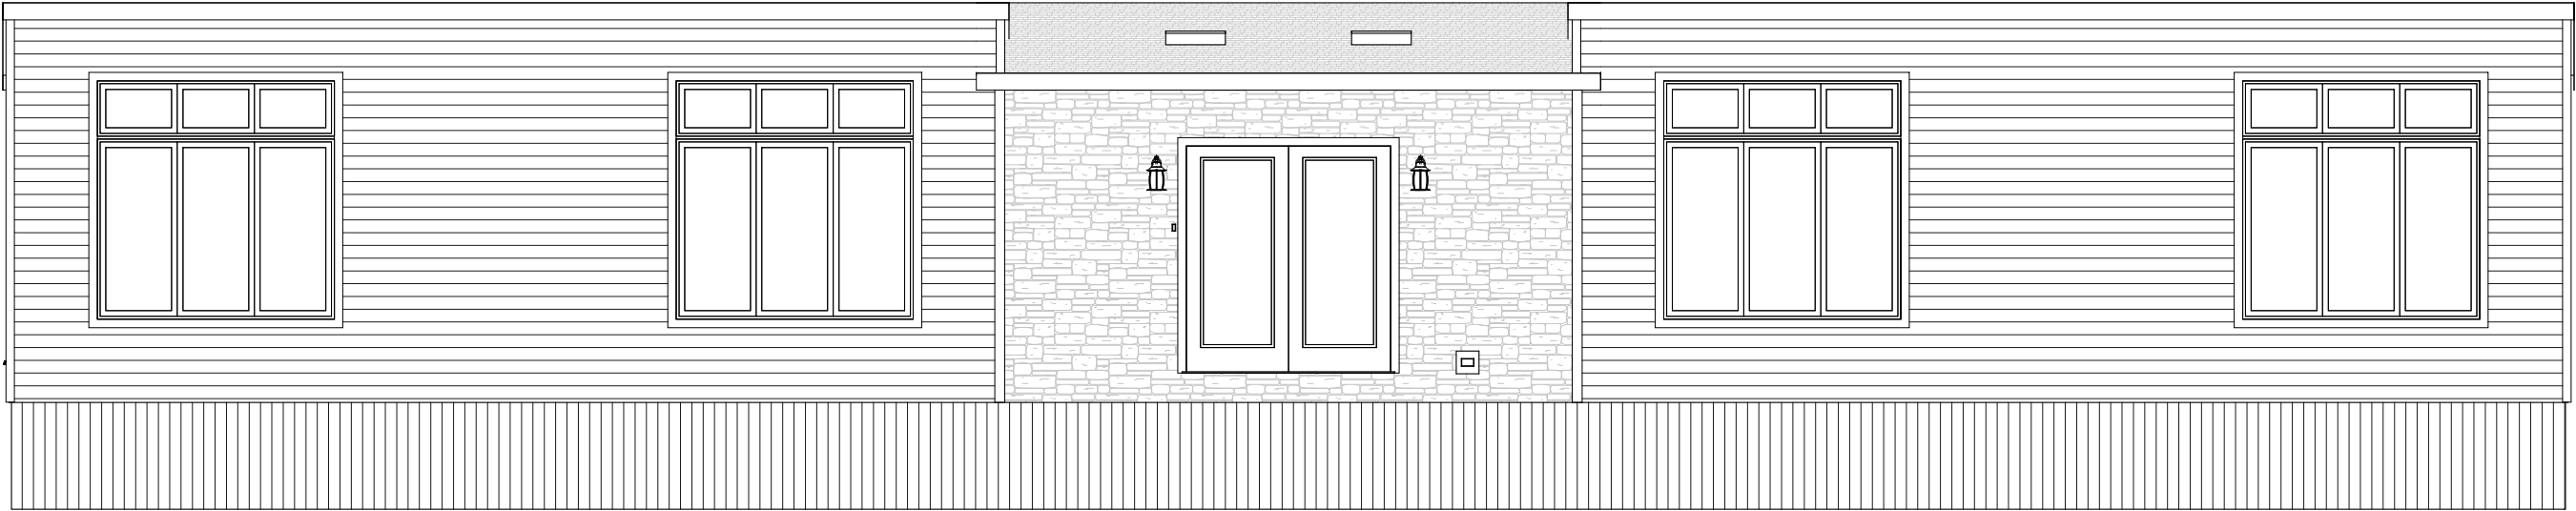

MINI HOME - FRONT ELEVATION

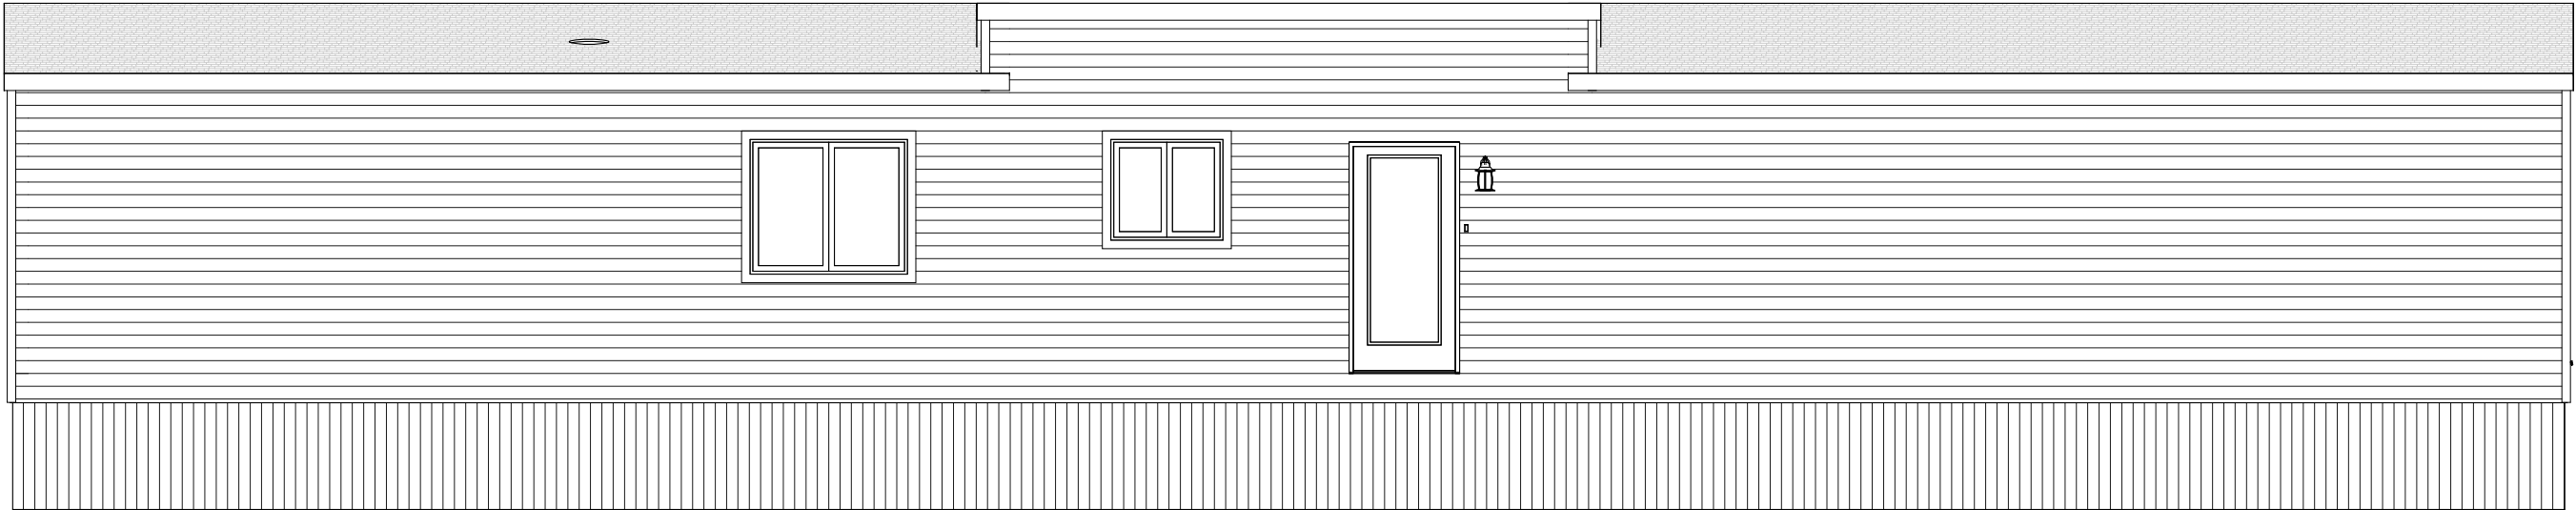

MINI HOME - REAR ELEVATION

Kent Homes

It makes beautiful sense

28 CHEMIN DU COUVENT

BOUCTOUCHE, NB

E4S 3B9

TEL.: (506) 743-2481

FAX.: (506) 743-2660

WWW.KENTHOMES.COM


PROPRIETARY COPYRIGHT 2017 KENT HOMES
THIS DRAWING WILL REMAIN THE PROPERTY OF KENT HOMES
WHETHER THE PROJECT FOR WHICH IT WAS MADE IS EXECUTED OR
NOT. THEY ARE NOT TO BE USED BY THE CLIENT ON ANY OTHER
PROJECTS OR EXTENSIONS TO THIS PROJECT, EXCEPT BY AGREEMENT
AND APPROPRIATE COMPENSATION TO KENT HOMES.

DISCLAIMER
THIS DESIGN DOCUMENT IS PREPARED SOLELY FOR THE USE BY THE
PARTY WITH WHOM KENT HOMES HAS ENTERED INTO A CONTRACT
AND THERE ARE NO REPRESENTATIONS OF ANY KIND MADE BY KENT
HOMES HAS NOT ENTERED INTO CONTRACT.


NO.	DESCRIPTION	DATE

DRAWN BY: C.A.S.
CHK BY: ENG
DATE: NOVEMBER 6_2017
SCALE: 3/16" = 1'-0"
PROJECT NO.: 56738-R2-AS BUILT
TYPE: 16'-0" X 75'-0" TECH HOME

TITLE:	#1989 - OFFICE ELEVATIONS - FRONT & REAR THE HOME CENTER
SHEET NO.:	2A-601

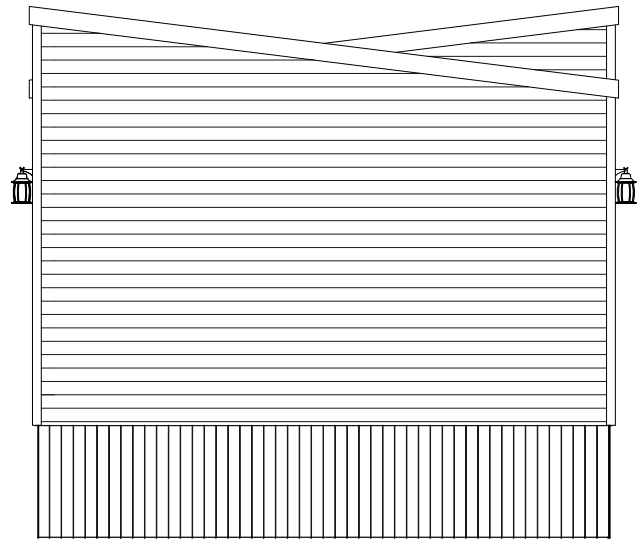

MINI HOME - RIGHT ELEVATION

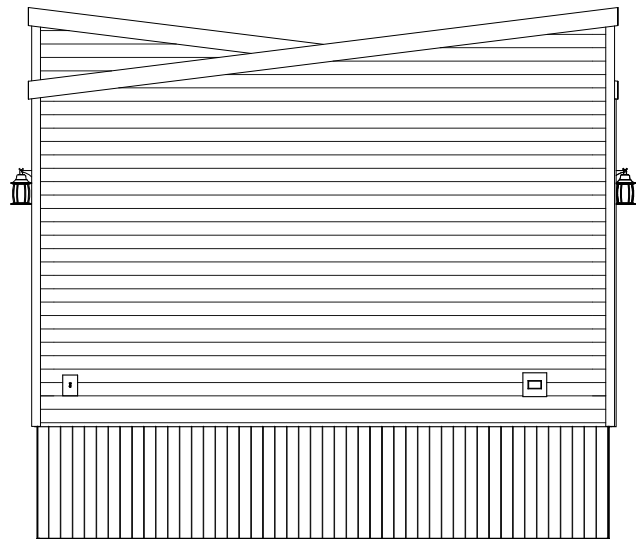

MINI HOME - LEFT ELEVATION

Kent Homes

It makes beautiful sense

28 CHEMIN DU COUVENT
BOUCTOUCHE, NB
E4S 3B9

TEL.: (506) 743-2481
FAX.: (506) 743-2660
WWW.KENTHOMES.COM

PROPRIETARY COPYRIGHT 2017 KENT HOMES
THIS DRAWING WILL REMAIN THE PROPERTY OF KENT HOMES
WHETHER THE PROJECT FOR WHICH IT WAS MADE IS EXECUTED OR
NOT. THEY ARE NOT TO BE USED BY THE CLIENT ON ANY OTHER
PROJECTS OR EXTENSIONS TO THIS PROJECT, EXCEPT BY AGREEMENT
AND APPROPRIATE COMPENSATION TO KENT HOMES.


DISCLAIMER
THIS DESIGN DOCUMENT IS PREPARED SOLELY FOR THE USE BY THE
PARTY WITH WHOM KENT HOMES HAS ENTERED INTO A CONTRACT
AND THERE ARE NO REPRESENTATIONS OF ANY KIND MADE BY KENT
HOMES HAS NOT ENTERED INTO CONTRACT.

NO.	DESCRIPTION	DATE

DRAWN BY: C.A.S.
CHK BY: ENG
DATE: NOVEMBER 6_2017
SCALE: 3/16" = 1'-0"
PROJECT NO.: 56738-R2-AS BUILT
TYPE: 16'-0" X 75'-0" TECH HOME

TITLE:	#1989 - OFFICE ELEVATIONS - LEFT & RIGHT THE HOME CENTER
SHEET NO.:	2A-602

SPECIAL MEMBRANE &
INCREASED NAILLING
PATTERN

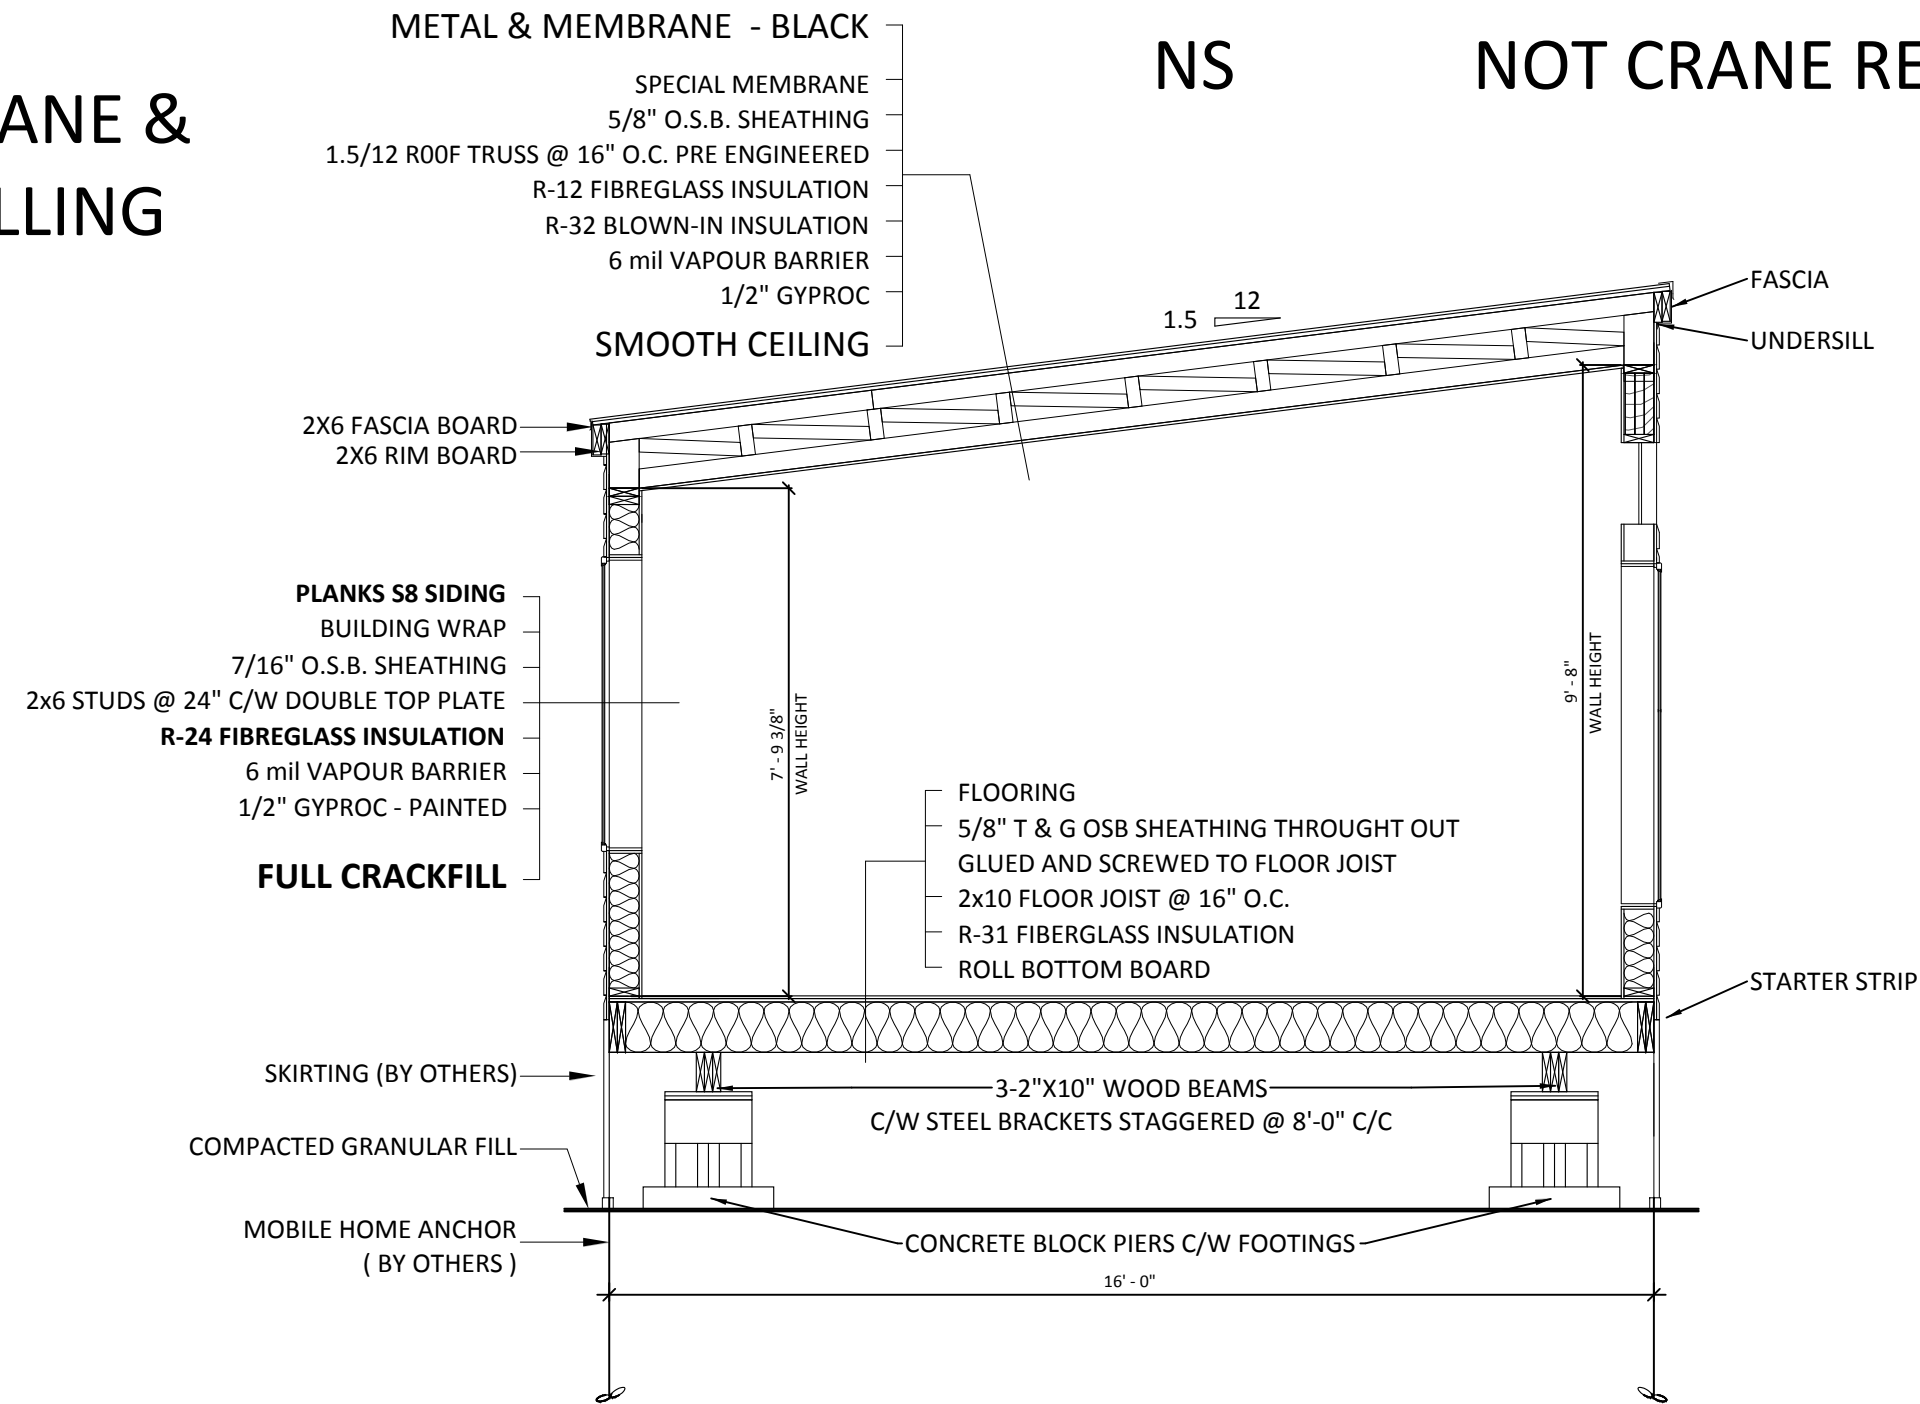

28 CHEMIN DU COUVENT
BOUCTOUCHE, NB
E4S 3B9

TEL.: (506) 743-2481
FAX.: (506) 743-2660
WWW.KENTHOMES.COM


PROPRIETARY COPYRIGHT 2017 KENT HOMES
THIS DRAWING WILL REMAIN THE PROPERTY OF KENT HOMES
WHETHER THE PROJECT FOR WHICH IT WAS MADE IS EXECUTED OR
NOT. THEY ARE NOT TO BE USED BY THE CLIENT ON ANY OTHER
PROJECTS OR EXTENSIONS TO THIS PROJECT, EXCEPT BY AGREEMENT
AND APPROPRIATE COMPENSATION TO KENT HOMES.

DISCLAIMER
THIS DESIGN DOCUMENT IS PREPARED SOLELY FOR THE USE BY THE
PARTY WITH WHOM KENT HOMES HAS ENTERED INTO A CONTRACT
AND THERE ARE NO REPRESENTATIONS OF ANY KIND MADE BY KENT
HOMES HAS NOT ENTERED INTO CONTRACT.


NO.	DESCRIPTION	DATE

DRAWN BY: C.A.S.
CHK BY: ENG
DATE: NOVEMBER 6_2017
SCALE: N.T.S.
PROJECT NO.: 56738-R2-AS BUILT
TYPE: 16'-0" X 75'-0" TECH HOME

TITLE:	#1989 - OFFICE CROSS SECTION THE HOME CENTER
SHEET NO.:	2A-701

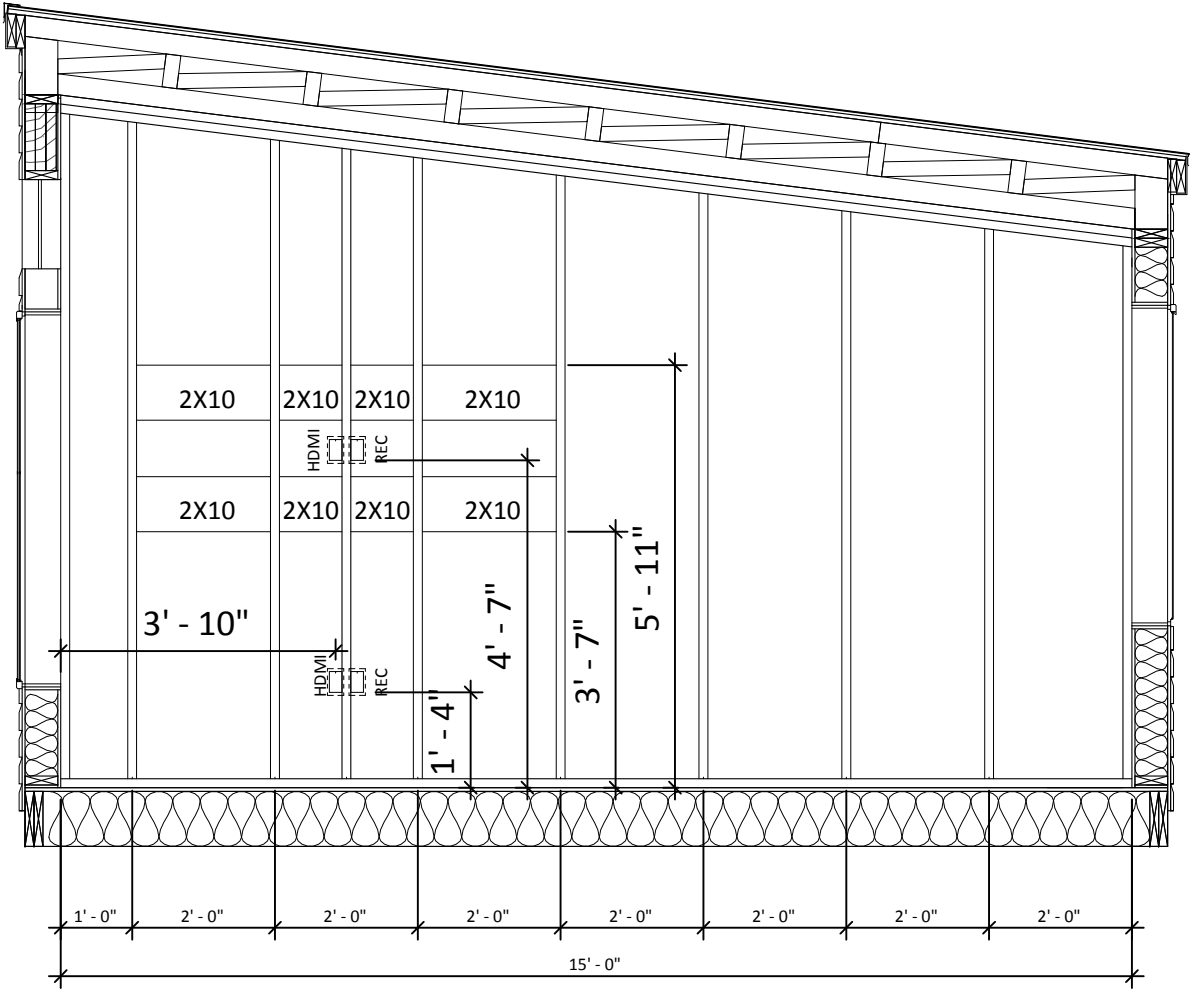

HDMI @ BEDROOM 2

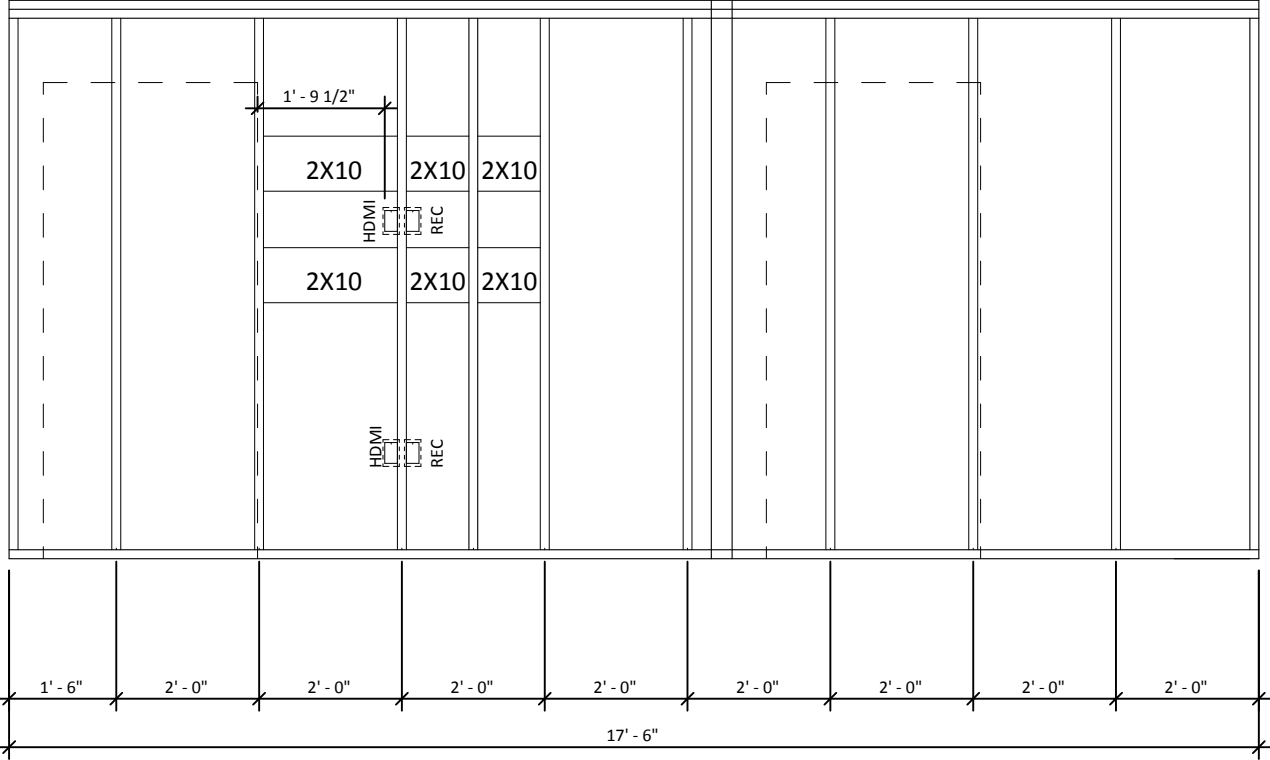

HDMI @ BEDROOM 3

Kent Homes

It makes beautiful sense

28 CHEMIN DU COUVENT
BOUCTOUCHE, NB
E4S 3B9

TEL.: (506) 743-2481
FAX.: (506) 743-2660
WWW.KENTHOMES.COM

PROPRIETARY COPYRIGHT 2017 KENT HOMES
THIS DRAWING WILL REMAIN THE PROPERTY OF KENT HOMES
WHETHER THE PROJECT FOR WHICH IT WAS MADE IS EXECUTED OR
NOT. THEY ARE NOT TO BE USED BY THE CLIENT ON ANY OTHER
PROJECTS OR EXTENSIONS TO THIS PROJECT, EXCEPT BY AGREEMENT
AND APPROPRIATE COMPENSATION TO KENT HOMES.

DISCLAIMER
THIS DESIGN DOCUMENT IS PREPARED SOLELY FOR THE USE BY THE
PARTY WITH WHOM KENT HOMES HAS ENTERED INTO A CONTRACT
AND THERE ARE NO REPRESENTATIONS OF ANY KIND MADE BY KENT
HOMES HAS NOT ENTERED INTO CONTRACT.

NO.	DESCRIPTION	DATE

DRAWN BY: C.A.S.
CHK BY: ENG
DATE: NOVEMBER 6_2017
SCALE: 3/8" = 1'-0"
PROJECT NO.: 56738-R2-AS BUILT
TYPE: 16'-0" X 75'-0" TECH HOME

TITLE:	#1989 - OFFICE DETAILS THE HOME CENTER
SHEET NO.:	2Z-000